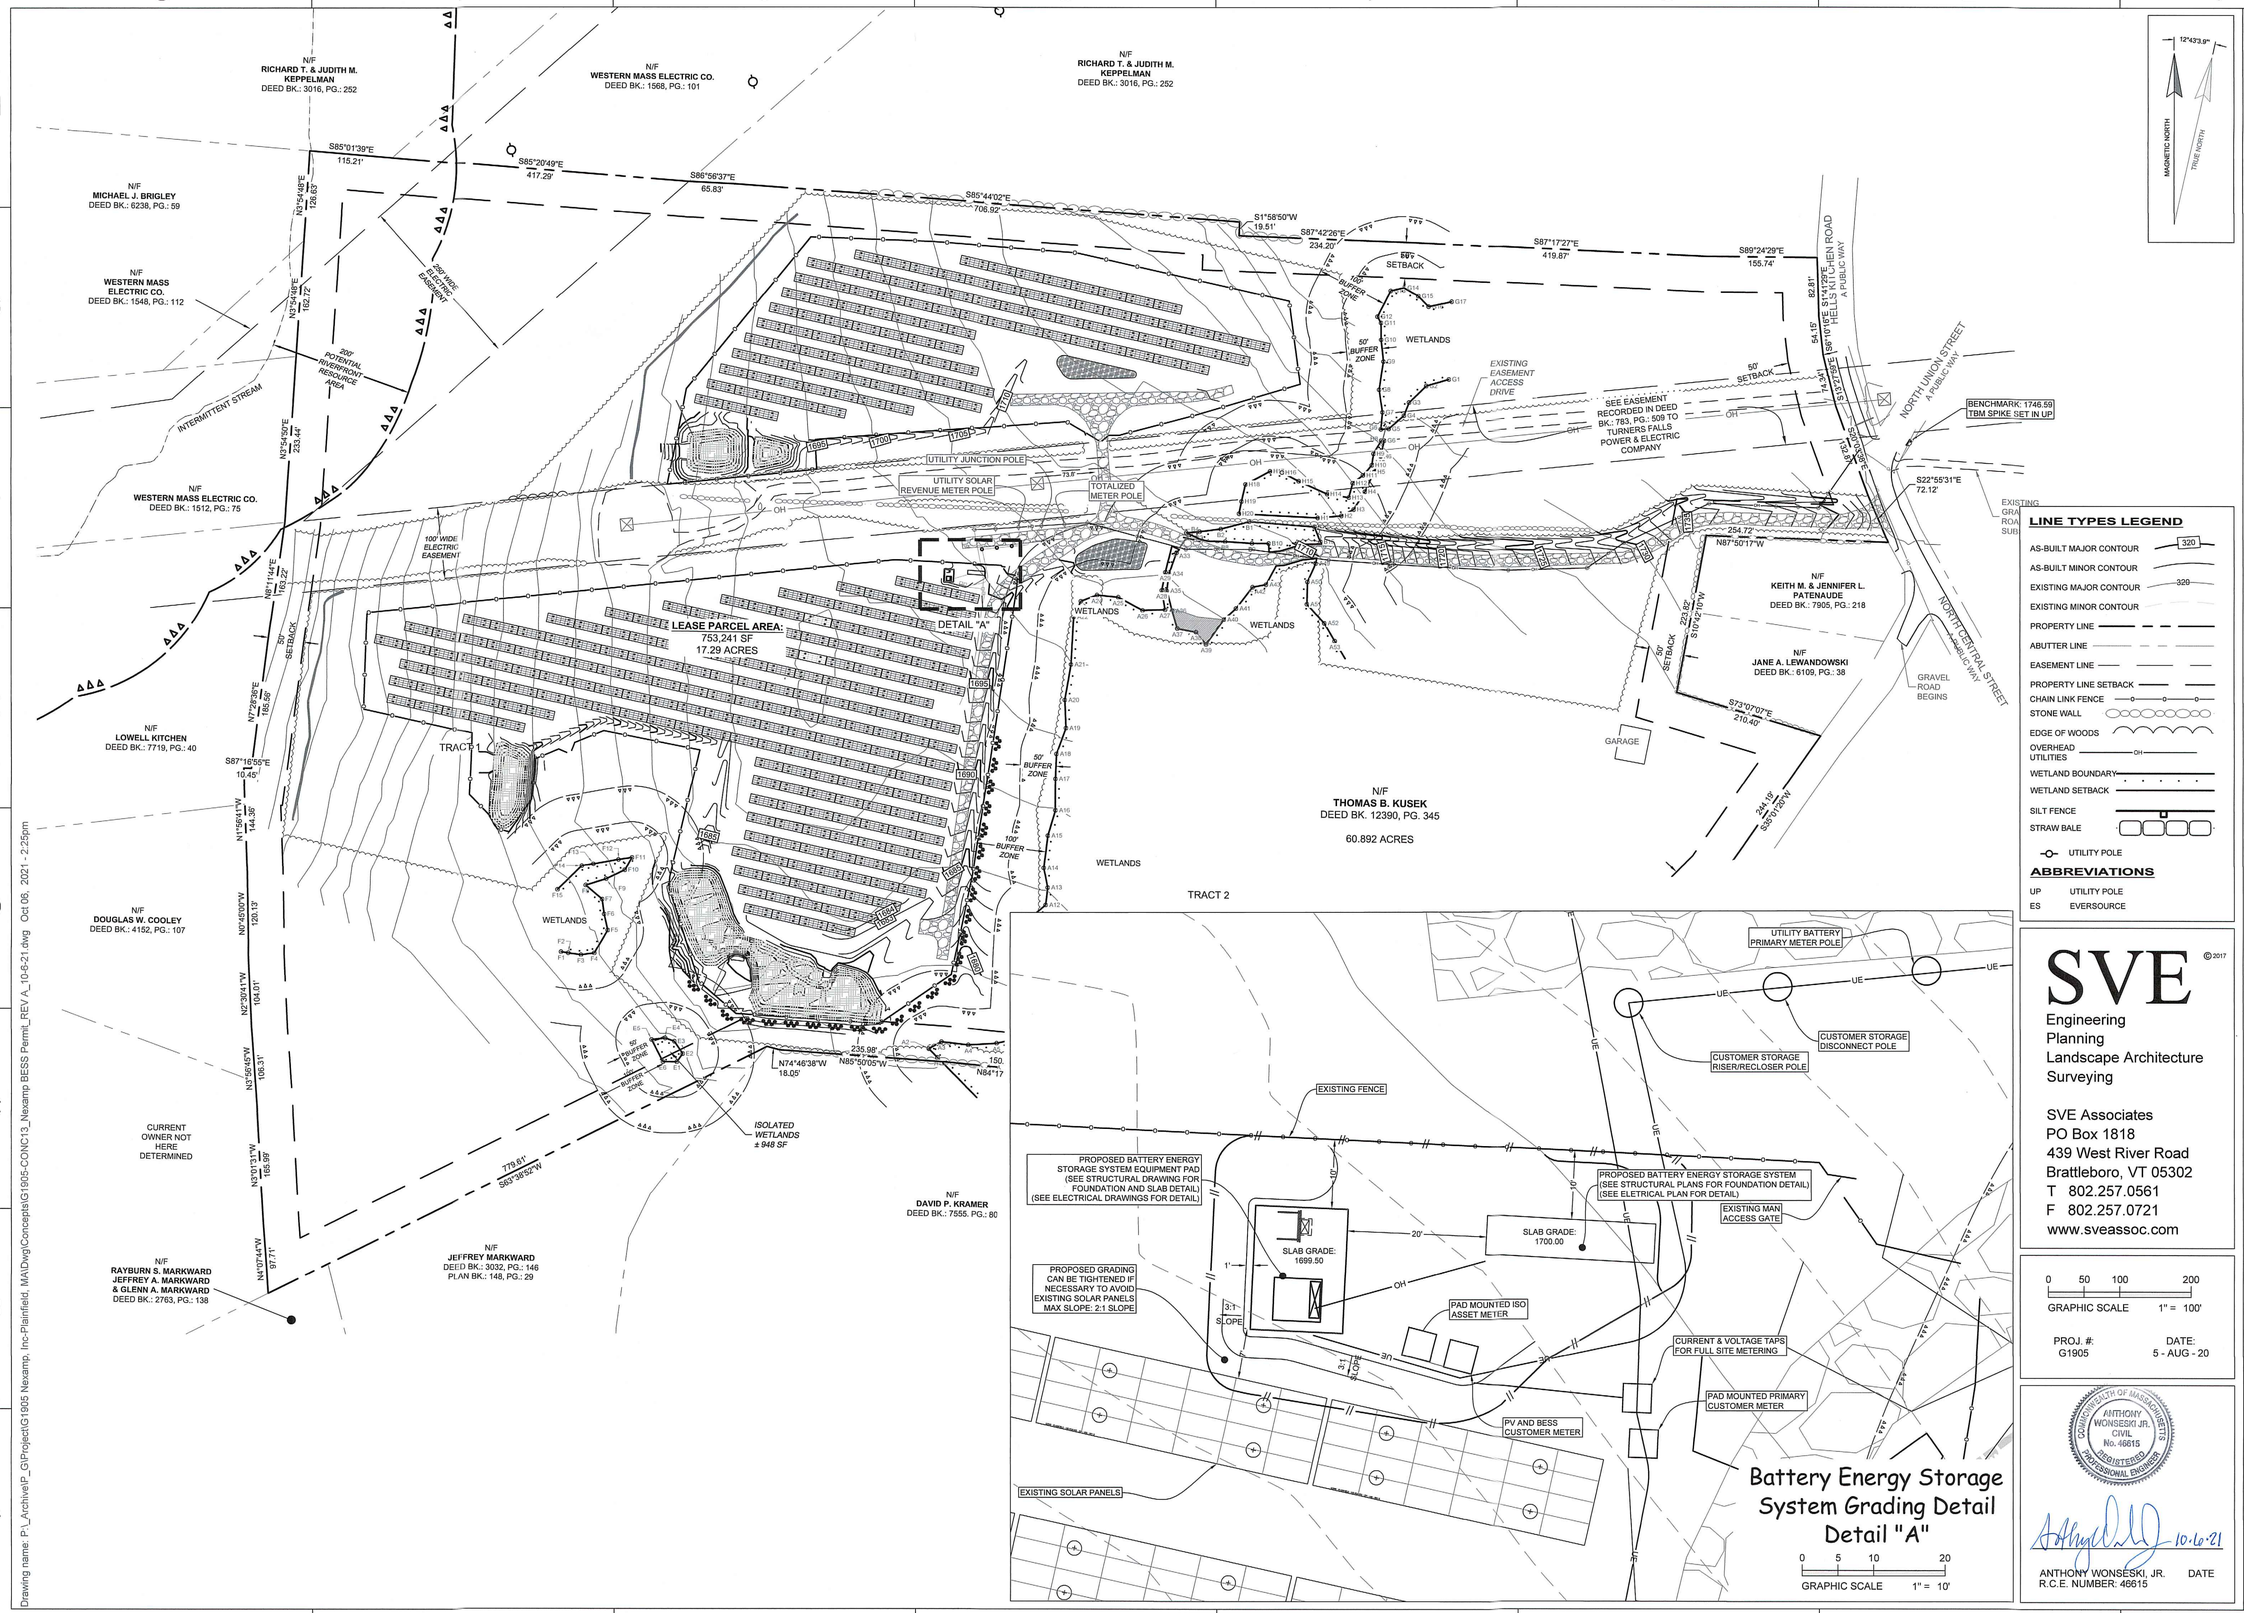

LINE TYPES LEGEND

- AS-BUILT MAJOR CONTOUR 320
- AS-BUILT MINOR CONTOUR
- EXISTING MAJOR CONTOUR 320
- EXISTING MINOR CONTOUR
- PROPERTY LINE
- ABUTTER LINE
- EASEMENT LINE
- PROPERTY LINE SETBACK
- CHAIN LINK FENCE
- STONE WALL
- EDGE OF WOODS
- OVERHEAD UTILITIES OH
- WETLAND BOUNDARY
- WETLAND SETBACK
- SILT FENCE
- STRAW BALE
- UTILITY POLE

ABBREVIATIONS

UP	UTILITY POLE
ES	EVERSOURCE

SVE ©2017
Engineering
Planning
Landscape Architecture
Surveying

SVE Associates
PO Box 1818
439 West River Road
Brattleboro, VT 05302
T 802.257.0561
F 802.257.0721
www.sveassoc.com

0 50 100 200
GRAPHIC SCALE 1" = 100'

PROJ. #: G1905
DATE: 5 - AUG - 20

COMMONWEALTH OF MASSACHUSETTS
ANTHONY WONSESKI JR.
CIVIL
No. 46615
REGISTERED PROFESSIONAL ENGINEER

10.6.21

ANTHONY WONSESKI, JR. DATE
R.C.E. NUMBER: 46615

nexamp
4 Liberty Square, 3rd Floor Boston, Massachusetts 02109
Tel: (617) 431-1440 Web: nexamp.com

Rev	Issued For	Date Issued
A	Changes to BESS Layout	Oct. 6, 2021

P.E. seal/Consultant:

Project:
Plainfield Solar, LLC
29 UNION STREET
PLAINFIELD, MA 01070

Drawing Title:
Battery Energy Storage System Permit Plan

Drawn by: M. Stodnicki Scale: 1" = 100' Date: August 5, 2020

Dwg No:	Size: D	Rev:
C-101		A

Company Confidential - This drawing or print is the property of Nexamp, Inc. and is subject to return on request. The design concepts and information contained herein are proprietary to Nexamp, Inc. and its subsidiaries and are submitted in confidence. They are not transferable and must be used only for the purpose for which the Drawing/print is expressly loaned. They must not be disclosed, reproduced detrimental to the interest of Nexamp, Inc. All patent rights are reserved unless they are expressly assigned in writing by a duly authorized representative of Nexamp, Inc.

Drawing name: P:_Archive\P_GI\Project\G1905 Nexamp, Inc-Plainfield, MA\Dwg\Concepts\G1905-CONC13_Nexamp BESS Permit_REV A_10-6-21.dwg Oct 06, 2021 - 2:25pm